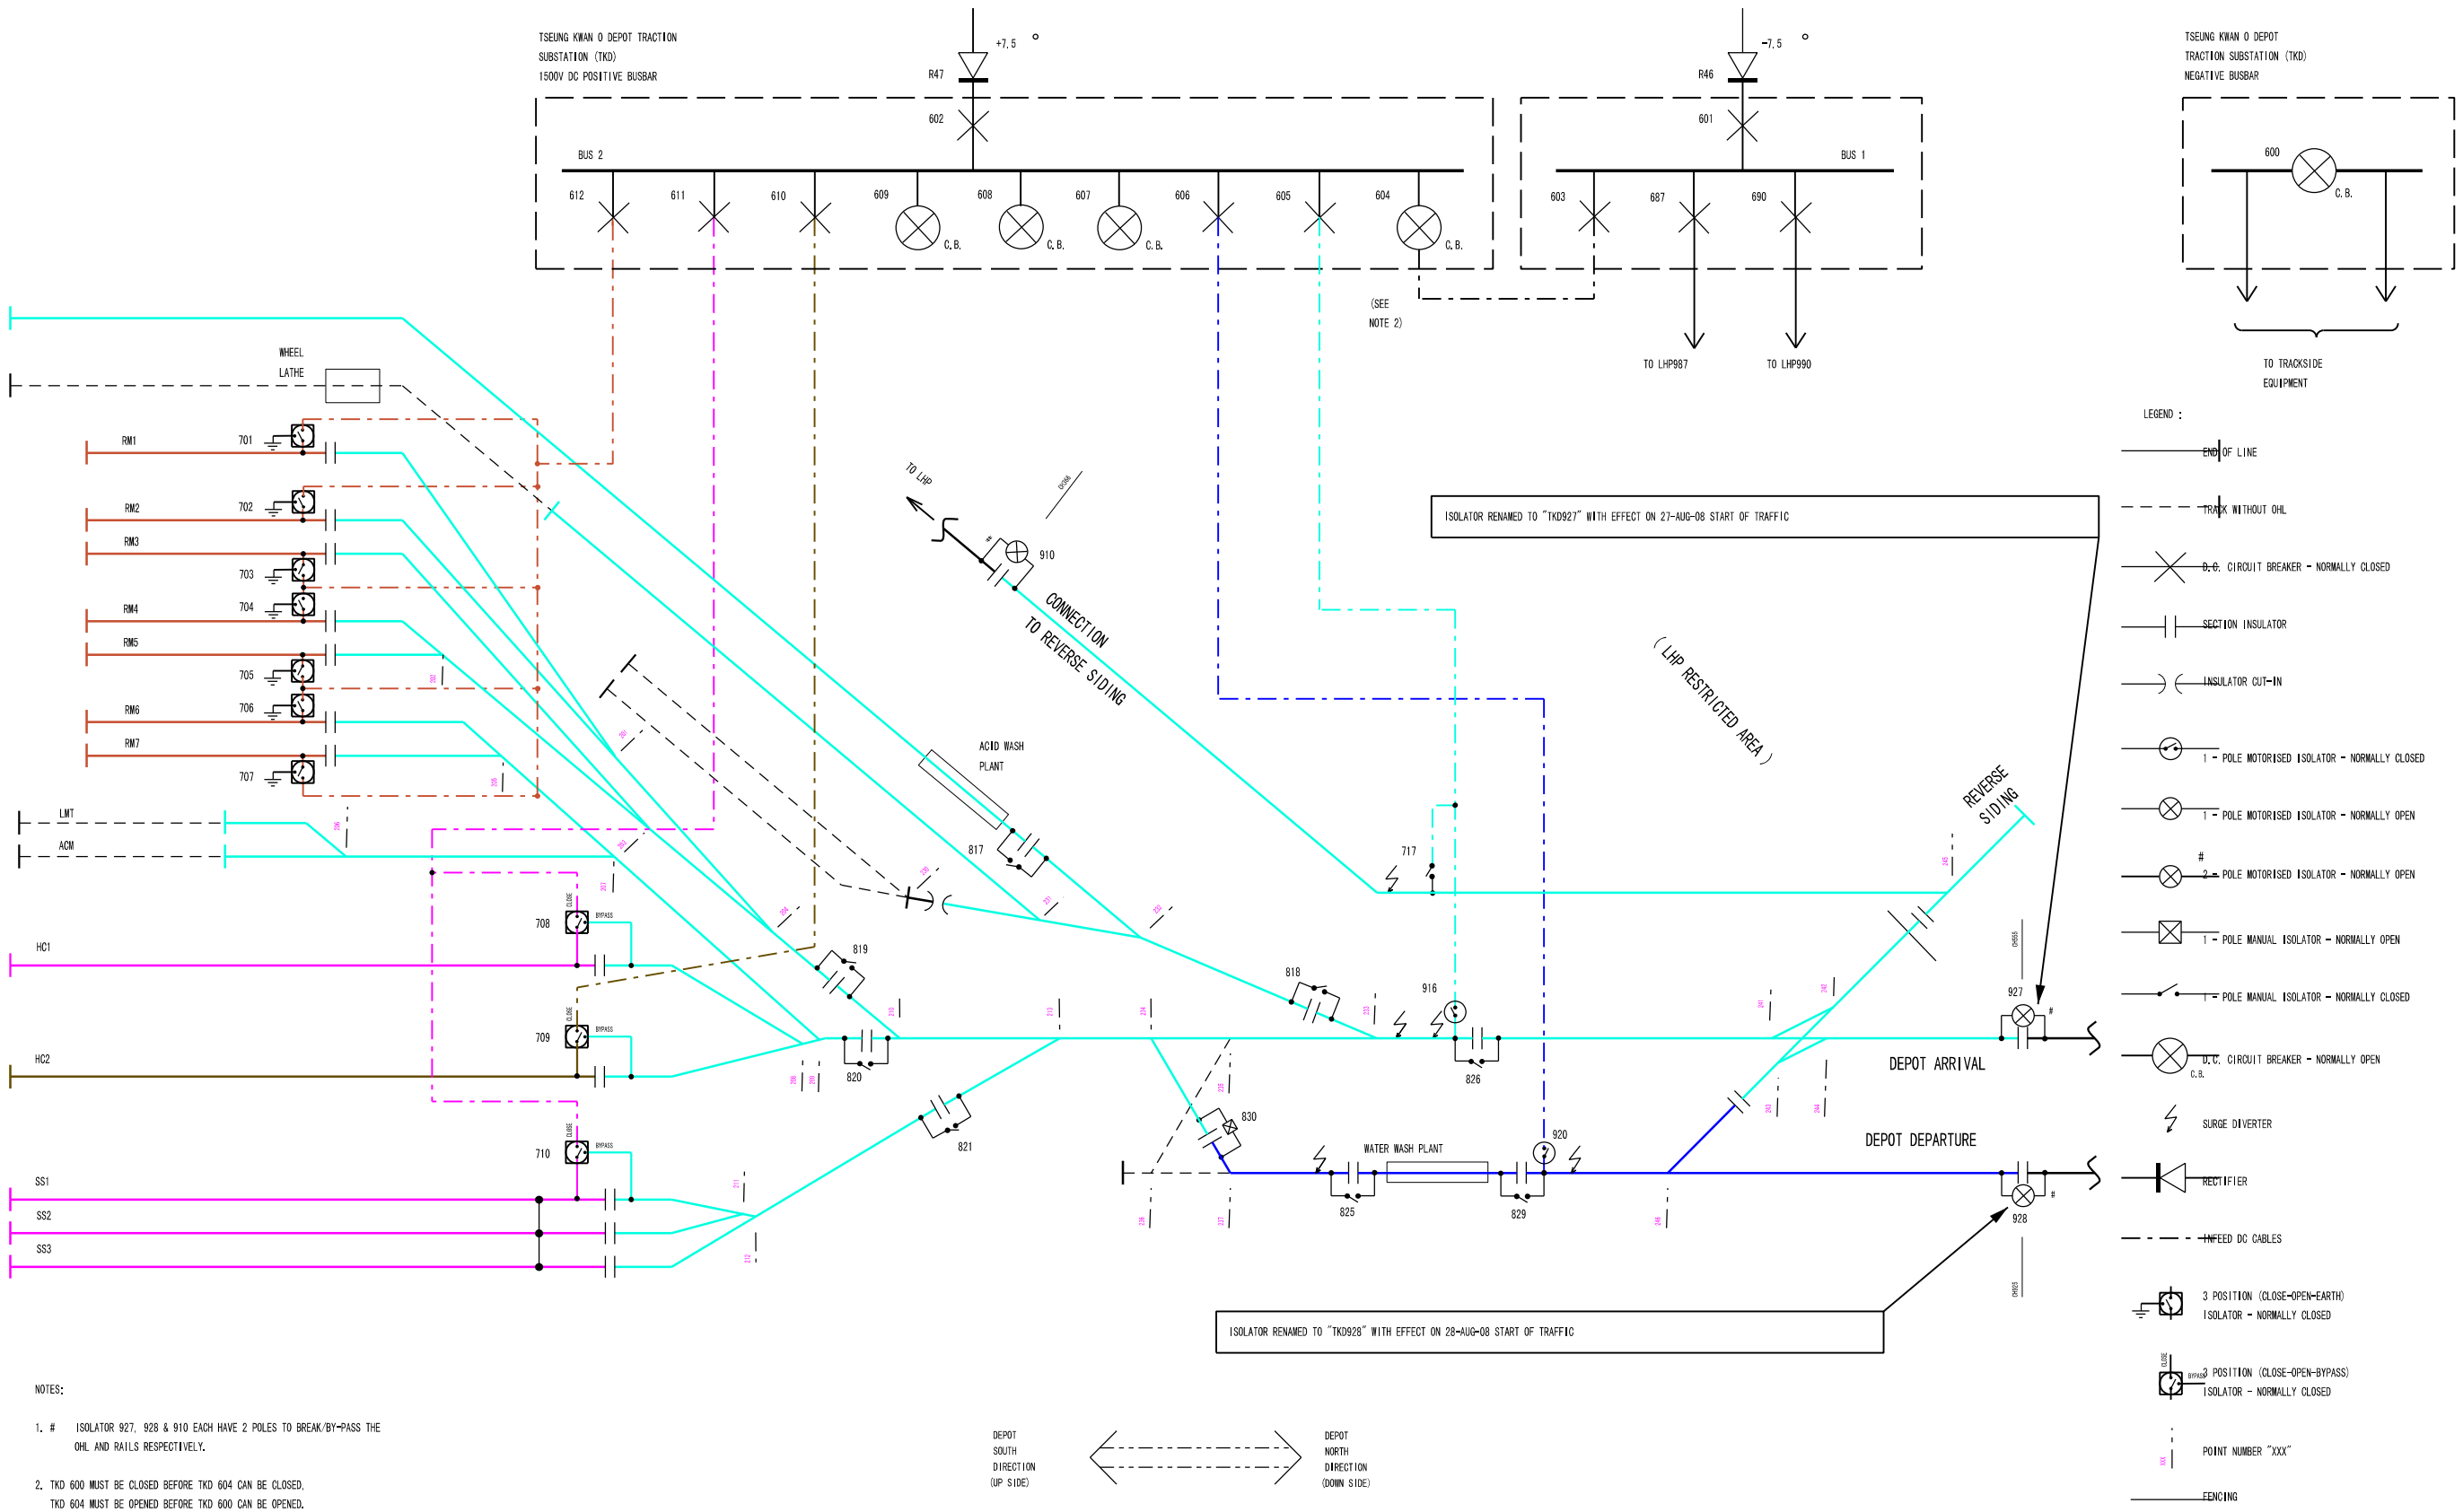

NOTES:

1. # ISOLATOR 927, 928 & 910 EACH HAVE 2 POLES TO BREAK/BY-PASS THE OHL AND RAILS RESPECTIVELY.

2. TKD 600 MUST BE CLOSED BEFORE TKD 604 CAN BE CLOSED, TKD 604 MUST BE OPENED BEFORE TKD 600 CAN BE OPENED.

REV	REVISION DESCRIPTION	REVISED/DATE		CHECKED/DATE		APPROVED/DATE	
F11	ISOLATOR RENAMED TO TKD927 & TKD928.	CSC	26/08/08	A. CHAN	26/08/08	P. LO	26/08/08
F10	TKD 919 DECOMMISSIONED.	CSC	14/08/08	A. CHAN	14/08/08	P. LO	14/08/08
F9	TEMPORARY INSULATOR CUT-IN AT TKD REVERSE SIDING REMOVED.	CSC	05/08/08	A. CHAN	05/08/08	P. LO	05/08/08
F8	ENERGISATION OF TKS EASTBOUND AND WESTBOUND TRACKS.	CSC	04/08/08	A. CHAN	04/08/08	P. LO	04/08/08
F7	ENERGISATION OF REVERSE SIDING AND CONNECTION TO REVERSE SIDING TRACKS.	CSC	02/08/08	A. CHAN	02/08/08	P. LO	02/08/08
F6	TKS DECLARED TO RESTRICTED AREA.	CSC	31/07/08	A. CHAN	31/07/08	P. LO	31/07/08
F5	TKD TRACTION CONFIGURATION REVISED FOR DEPOT BOUNDARY RELOCATION AT ARRIVAL TRACK UNDER TKS PROJECT.	CSC	20/07/08	A. CHAN	20/07/08	P. LO	20/07/08
F4	TKD TRACTION CONFIGURATION REVISED FOR DEPOT BOUNDARY RELOCATION AT DEPARTURE TRACK UNDER TKS PROJECT.	CSC	12/07/08	A. CHAN	12/07/08	P. LO	12/07/08
F3	POSITION OF "TKD 830" REVISED	CSC	20/06/08	A. CHAN	20/06/08	P. LO	20/06/08
F2	ISOLATOR "TKD 829" AND "TKD 830" ADDED	CSC	20/06/08	A. CHAN	20/06/08	P. LO	20/06/08
F1	TEMP. ISOLATOR "TKD 899" AND JUMPER CABLE AT "TKD 709" REMOVED AND TKS DEFINED AREA ADDED	TFY	28/05/08	A. CHAN	28/05/08	P. LO	28/05/08
E	SECTION INSULATOR AT ACID WASH PLANT UP REMOVED AS PER EDCO ZMF8897	AME	01/04/08	A. CHAN	01/04/08	P. LO	01/04/08
D	TEMP. ISOLATOR "TKD 899" ADDED, AND SECTION INSULATOR OF TKD 709 BYPASSED FOR TKS NOISE BARRIER CONSTRUCTION	SFK	23/06/07	A. CHAN	23/06/07	P. LO	23/06/07
C	THE AS-BUILT AND PRINT L.S. ADDED	KWT	20/01/03	A. CHAN	20/01/03	P. LO	20/01/03
B	ISOLATORS 83 808,809,810 DELETED IN ORIG. NEGATIVE CB ADDED	A. CHAN	16/05/02	C.N. LI	16/05/02	P. LO	16/05/02
A	AS BUILT PER 606 CONTRACT	A. CHAN	08/05/02	C.N. LI	08/05/02	P. LO	08/05/02

DO NOT SCALE DRAWINGS. VERIFY ALL DIMENSIONS ON SITE.
© MTR CORPORATION LIMITED 2000
COPYRIGHT IN RESPECT OF THIS DOCUMENT IS OWNED BY MTR CORPORATION LIMITED OF HONG KONG. NO REPRODUCTION OF THE DOCUMENT OR ANY PART BY WHATSOEVER MEANS IS PERMITTED WITHOUT THE PRIOR WRITTEN CONSENT OF MTR CORPORATION LIMITED.

MTRC REFERENCE NO.

CONTRACTOR REFERENCE NO.
606/OHL/ESD/001

	INITIAL	DESIGNATION	DATE
DRAWN	J. L.	CADD SUP.	17.01.02
DESIGNED	-	-	-
CHECKED	CW LI	PDM	25-01.02
APPROVED	P. LO	SEE(TS)	25.01.02
CAD FILE NAME	41101001.DGN		

地鐵公司 MTR Corporation

TITLE
TSEUNG KWAN O DEPOT
OVERHEAD LINES
ELECTRICAL SECTION DIAGRAM

SCALE NTS
OCD DRAWING NO. 0D4/202/41101/0001
F11

A2 SIZE. 594 x 420mm. TYPE 3