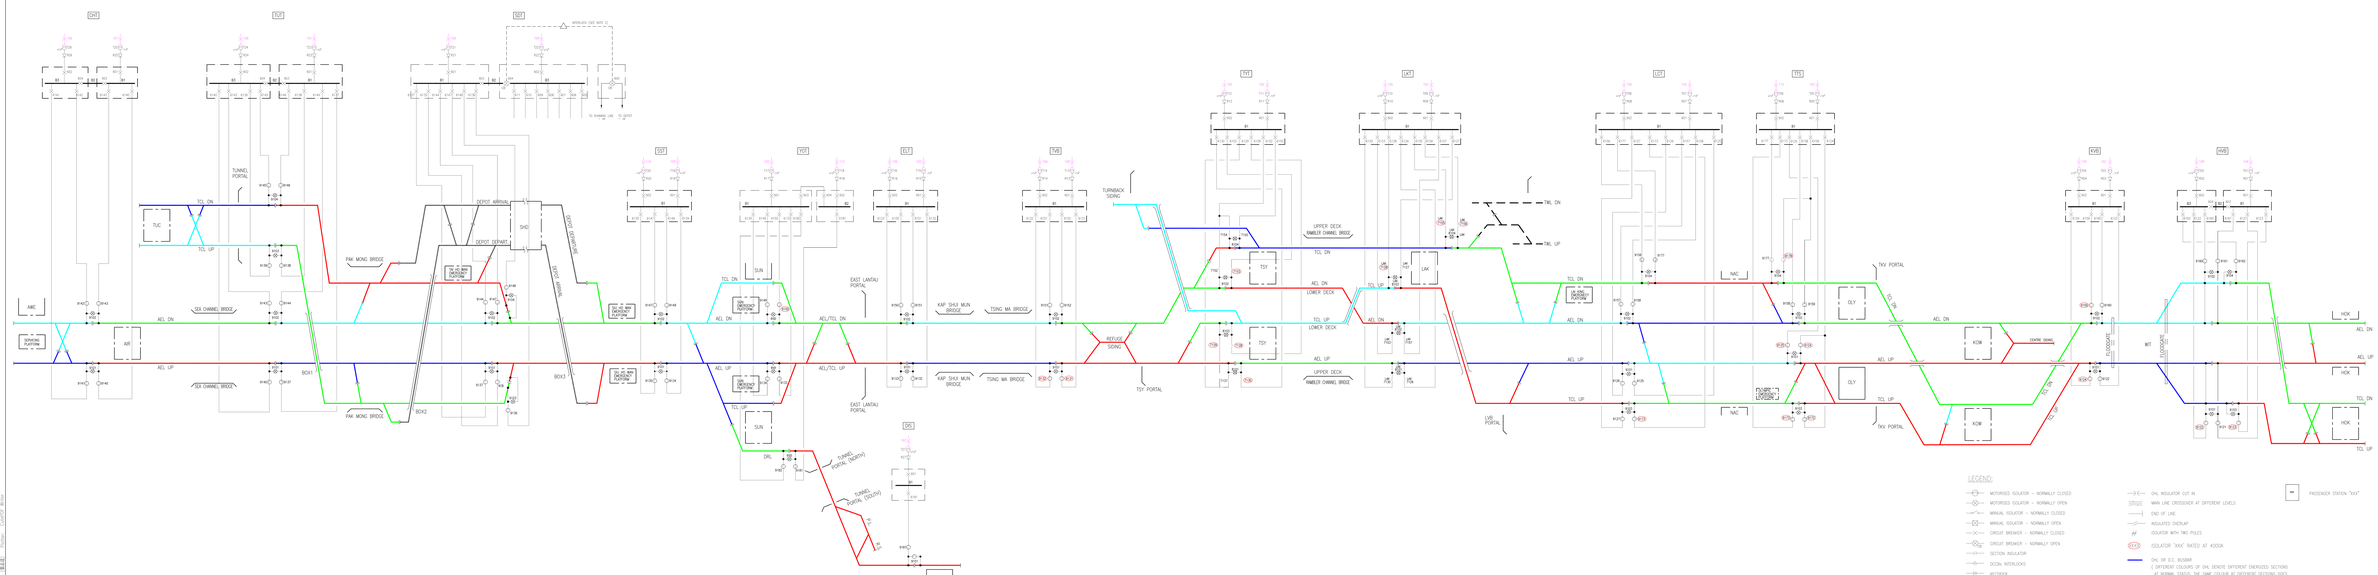


| REV | DESCRIPTION | BY | DATE | APPROVED |
|---|---|---|---|---|
| I | ISOLATOR LAK B105 FOR S-EW PROJECT (C&R No: C5117) DECOMMISSIONED. | CS C. | 19/AUG/16 | A. CHAN |
| H | ADD ISOLATOR LAK B105 FOR S-EW PROJECT (C&R No: C5117). DRAWING TITLE BLOCK REVISED. | CS C. | 14/FEB/16 | A. CHAN |
| G | SDT BUSBAR NOS. REVISED | A. CHAN | 09/NOV/06 | P. LO |
| F | DRAWING REVISED TO INCLUDE "AWE" | A. CHAN | 20/DEC/05 | P. LO |
| E | OHL AT SVP REINSTATED + DIS OPENED | A. CHAN | 09/SEP/05 | P. LO |
| D | CONFIGURATION OF YOT CORRECTED | A. CHAN | 22/FEB/05 | P. LO |
| C | CONFIGURATION OF KVB CORRECTED | A. CHAN | 07/FEB/05 | P. LO |
| B | DRAWING REVISED TO INCLUDE LAK2 AND DRL_33kV NETWORK DELETED. | A. CHAN | 23/JAN/05 | P. LO |
| A | FIRST ISSUE FOR AS-CONSTRUCTED DRAWING | --- | --- | --- |

| | | | |
|---|---|---|---|
| DRAWN | P.C. YU | D'MAN | |
| DESIGNED | --- | --- | |
| CHECKED | C.W. LI | PDM | |
| APPROVED | P. LO | SEE(TS) | |
| DATE | 25/MAR/1999 | | |

© MTR CORPORATION (C.I.) LIMITED. ALL RIGHTS RESERVED. THIS DRAWING IS THE COPYRIGHT OF MTR CORPORATION (C.I.) LIMITED. NO REPRODUCTION OF THIS DRAWING IN WHOLE OR IN PART BY WHATEVER MEANS IS PERMITTED WITHOUT THE PRIOR WRITTEN CONSENT OF THE MTR CORPORATION LIMITED.

MTR

ORIGINATOR: OPERATIONS DIVISION | TECHNICAL & ENGINEERING SERVICES DEPARTMENT

CAD REF: OD4_201_00601_0011_1.dwg

TITLE: 1500V D.C. POWER SYSTEM SINGLE LINE DIAGRAM ( FOR AEL, TCL, & DRL )

SCALE: N.T.S.

DRAWING NO.: OD4/201/00601/0011

REV.: I

Filename: S:\OD4\DGN\OD4_201_00601_0011_1.dwg
Plotted By: CHEUNG Kwan On Tuesday 19 AUG 2008 at 09:49
Xref(s):